

STATE OF UTAH
DEPARTMENT OF NATURAL RESOURCES
DIVISION OF OIL, GAS AND MINING
1594 West North Temple - Suite 1210
Box 145801
Salt Lake City, Utah 84114-5801
Telephone: (801) 538-5291
Fax: (801) 359-3940

LARGE MINING OPERATIONS 2006 PROGRESS REPORT
January 1, 2006 to December 31, 2006

The information required in this form are based on provisions of the Mined Land Reclamation Act, Title 40-8, and the rules as under the Utah Minerals Regulatory Program.

1. Mine Permit Number: M/023/016
2. Mine Name: Levan - Chicken Creek
3. Name of Operator/Permittee: Sunroc Corporation

Note: If Operator's address, company representative or phone number have changed, please provide a replacement page to the Notice of Intention.

4. Mine Location: 17 miles East of Levan - Chicken Creek Canyon

5. Report the gross amount of ore mined and waste moved, as well as the arrangement, positioning, or distribution of the material:

Gross Ore Mined 102,136 Tons, or _____ yd³

Waste Material Moved 0 Tons, or _____ yd³

New Disturbance 5.45 Acres during 2006

Area Reclaimed 0 Acres during 2006

Total Disturbed Area 48.65 Acres*

Was the ore shipped off site? If not, where is the ore located? yes

Where is the waste located? _____

*Total life of mine disturbance to the end of 2006.

6. Briefly describe the reclamation work performed during the past year. A map showing reclaimed areas and dates is suggested. (Submit form MR-SITE for an application for full or partial bond/site release).

none

7. Include an updated map depicting surface disturbance and reclamation performed during the year, prepared in accordance with Rule R647-4-105.

I hereby certify, under penalties of law, the information provided in this report is true and correct to the best of my knowledge and belief.

Name (Typed or Print): Tony Christofferson


Title of Operator: Sunroc Corporation - Property/Environmental Manager

Signature of Operator: Tony Christofferson

Date: 1-30-07

RECEIVED

JAN 30 2007

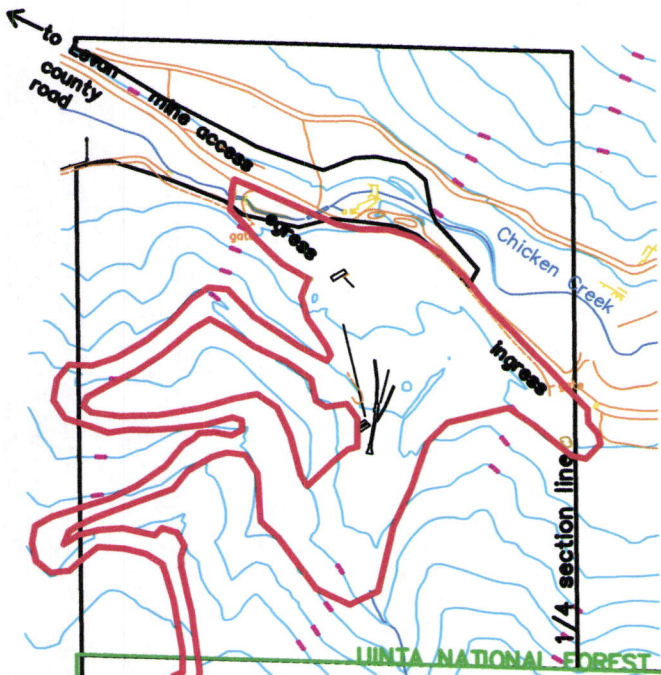

Scale: 1" = 500'


DISTURBED AREA MAP
of the
LEVAN CHICKEN CREEK
(WEST MINE) M/023/016


HE DAVIS CONSTRUCTION
Spanish Fork, Utah

contour interval 50'

Disturbed Area

Date: 10/4/05	Drawing # III - A W
---------------	------------------------

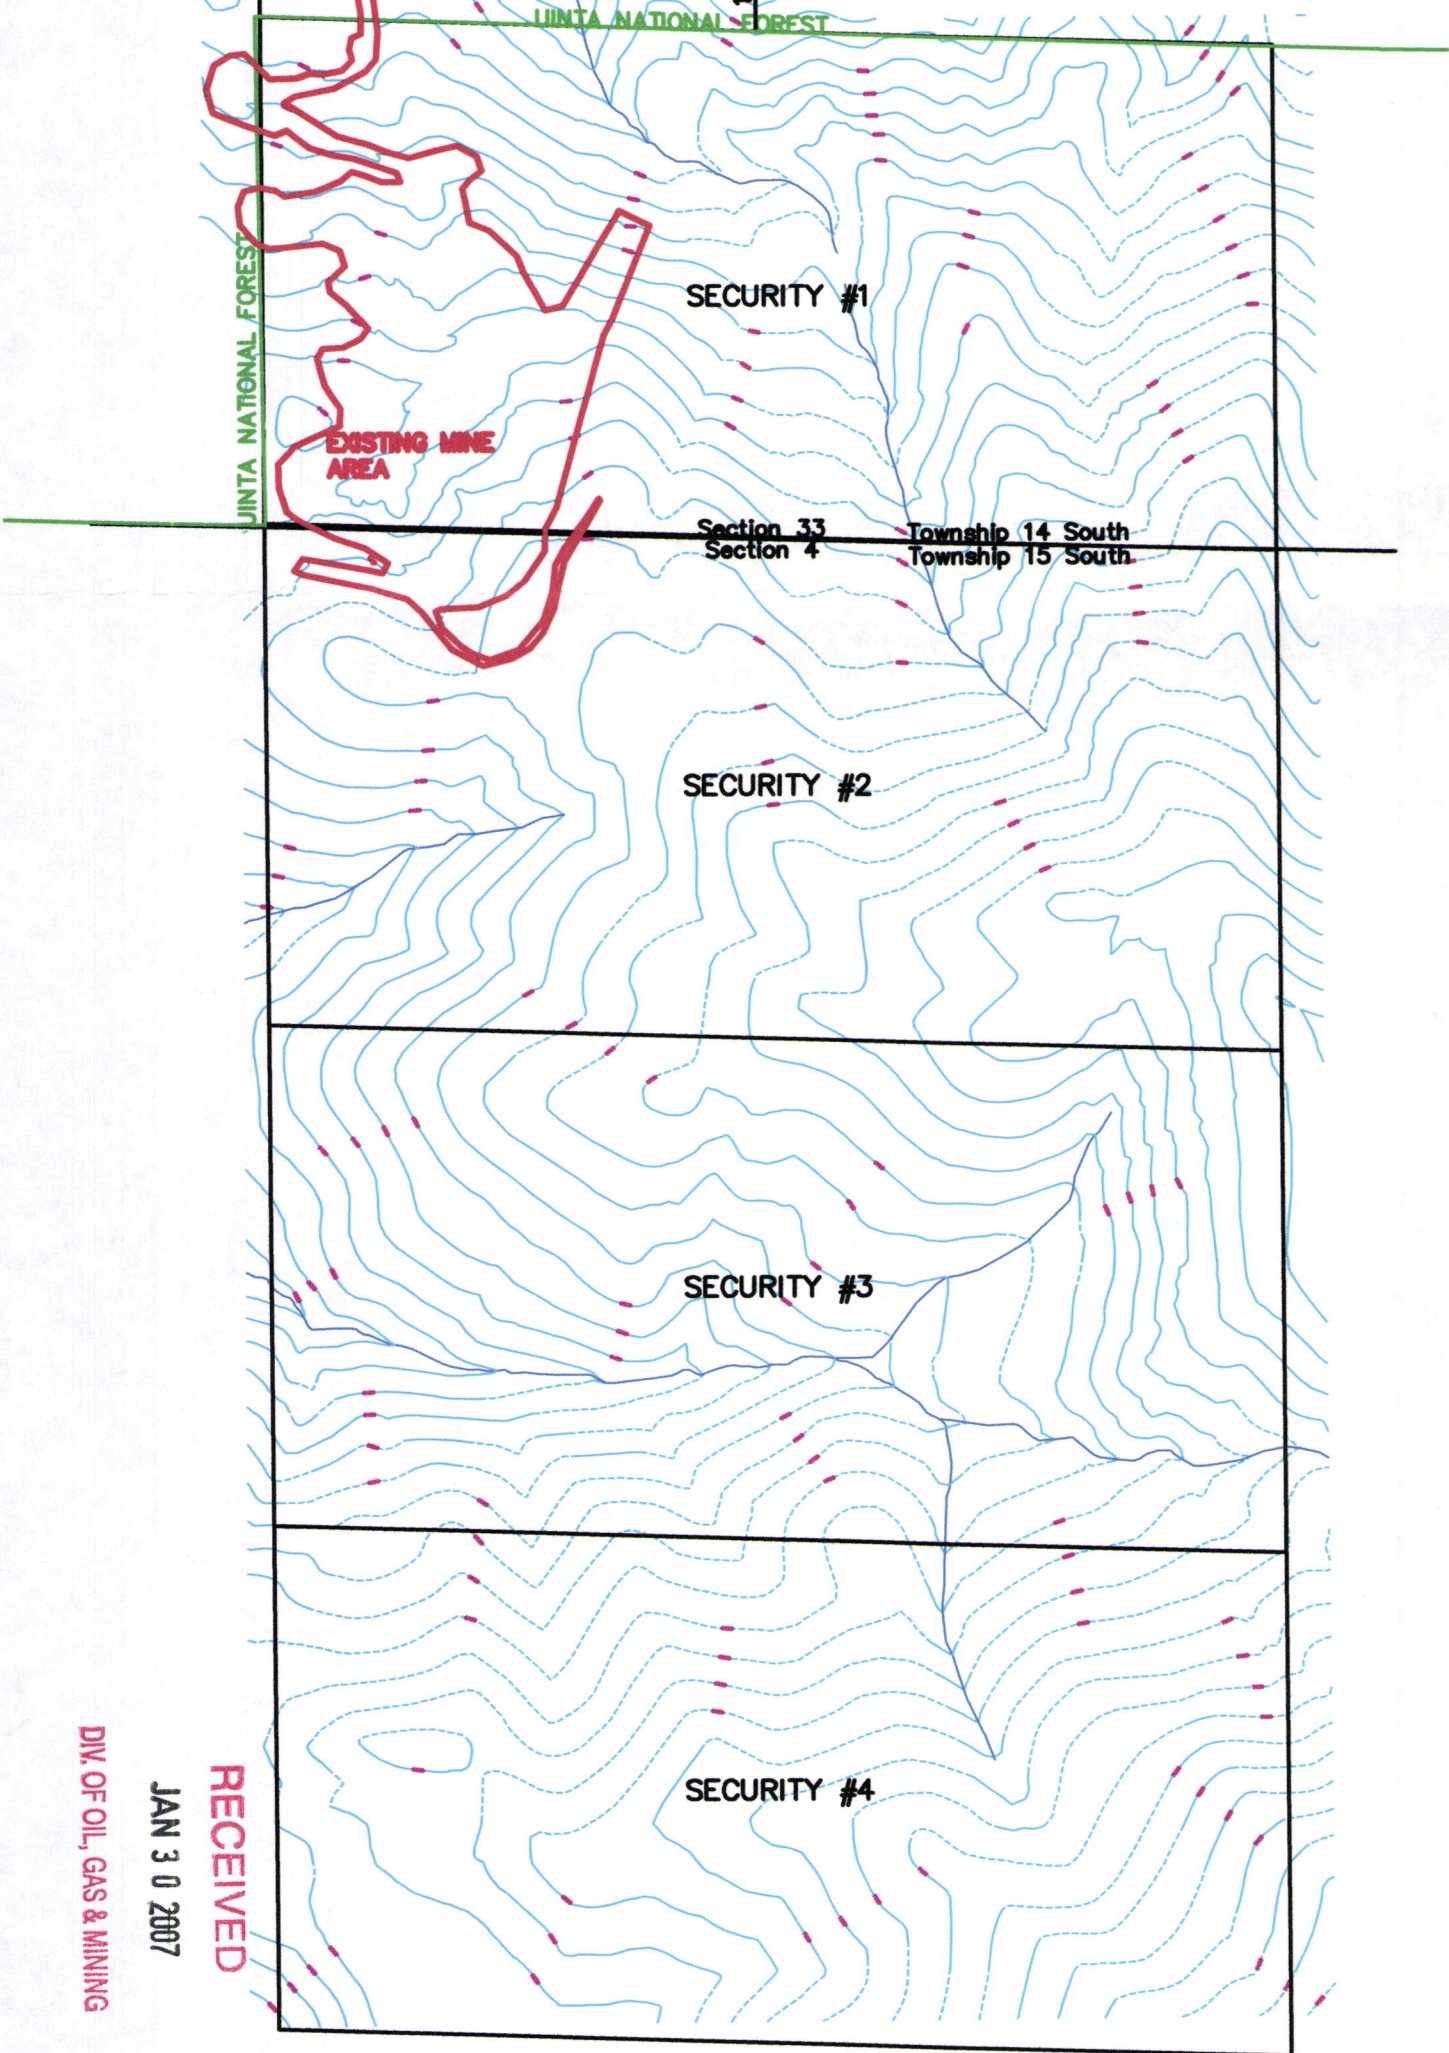

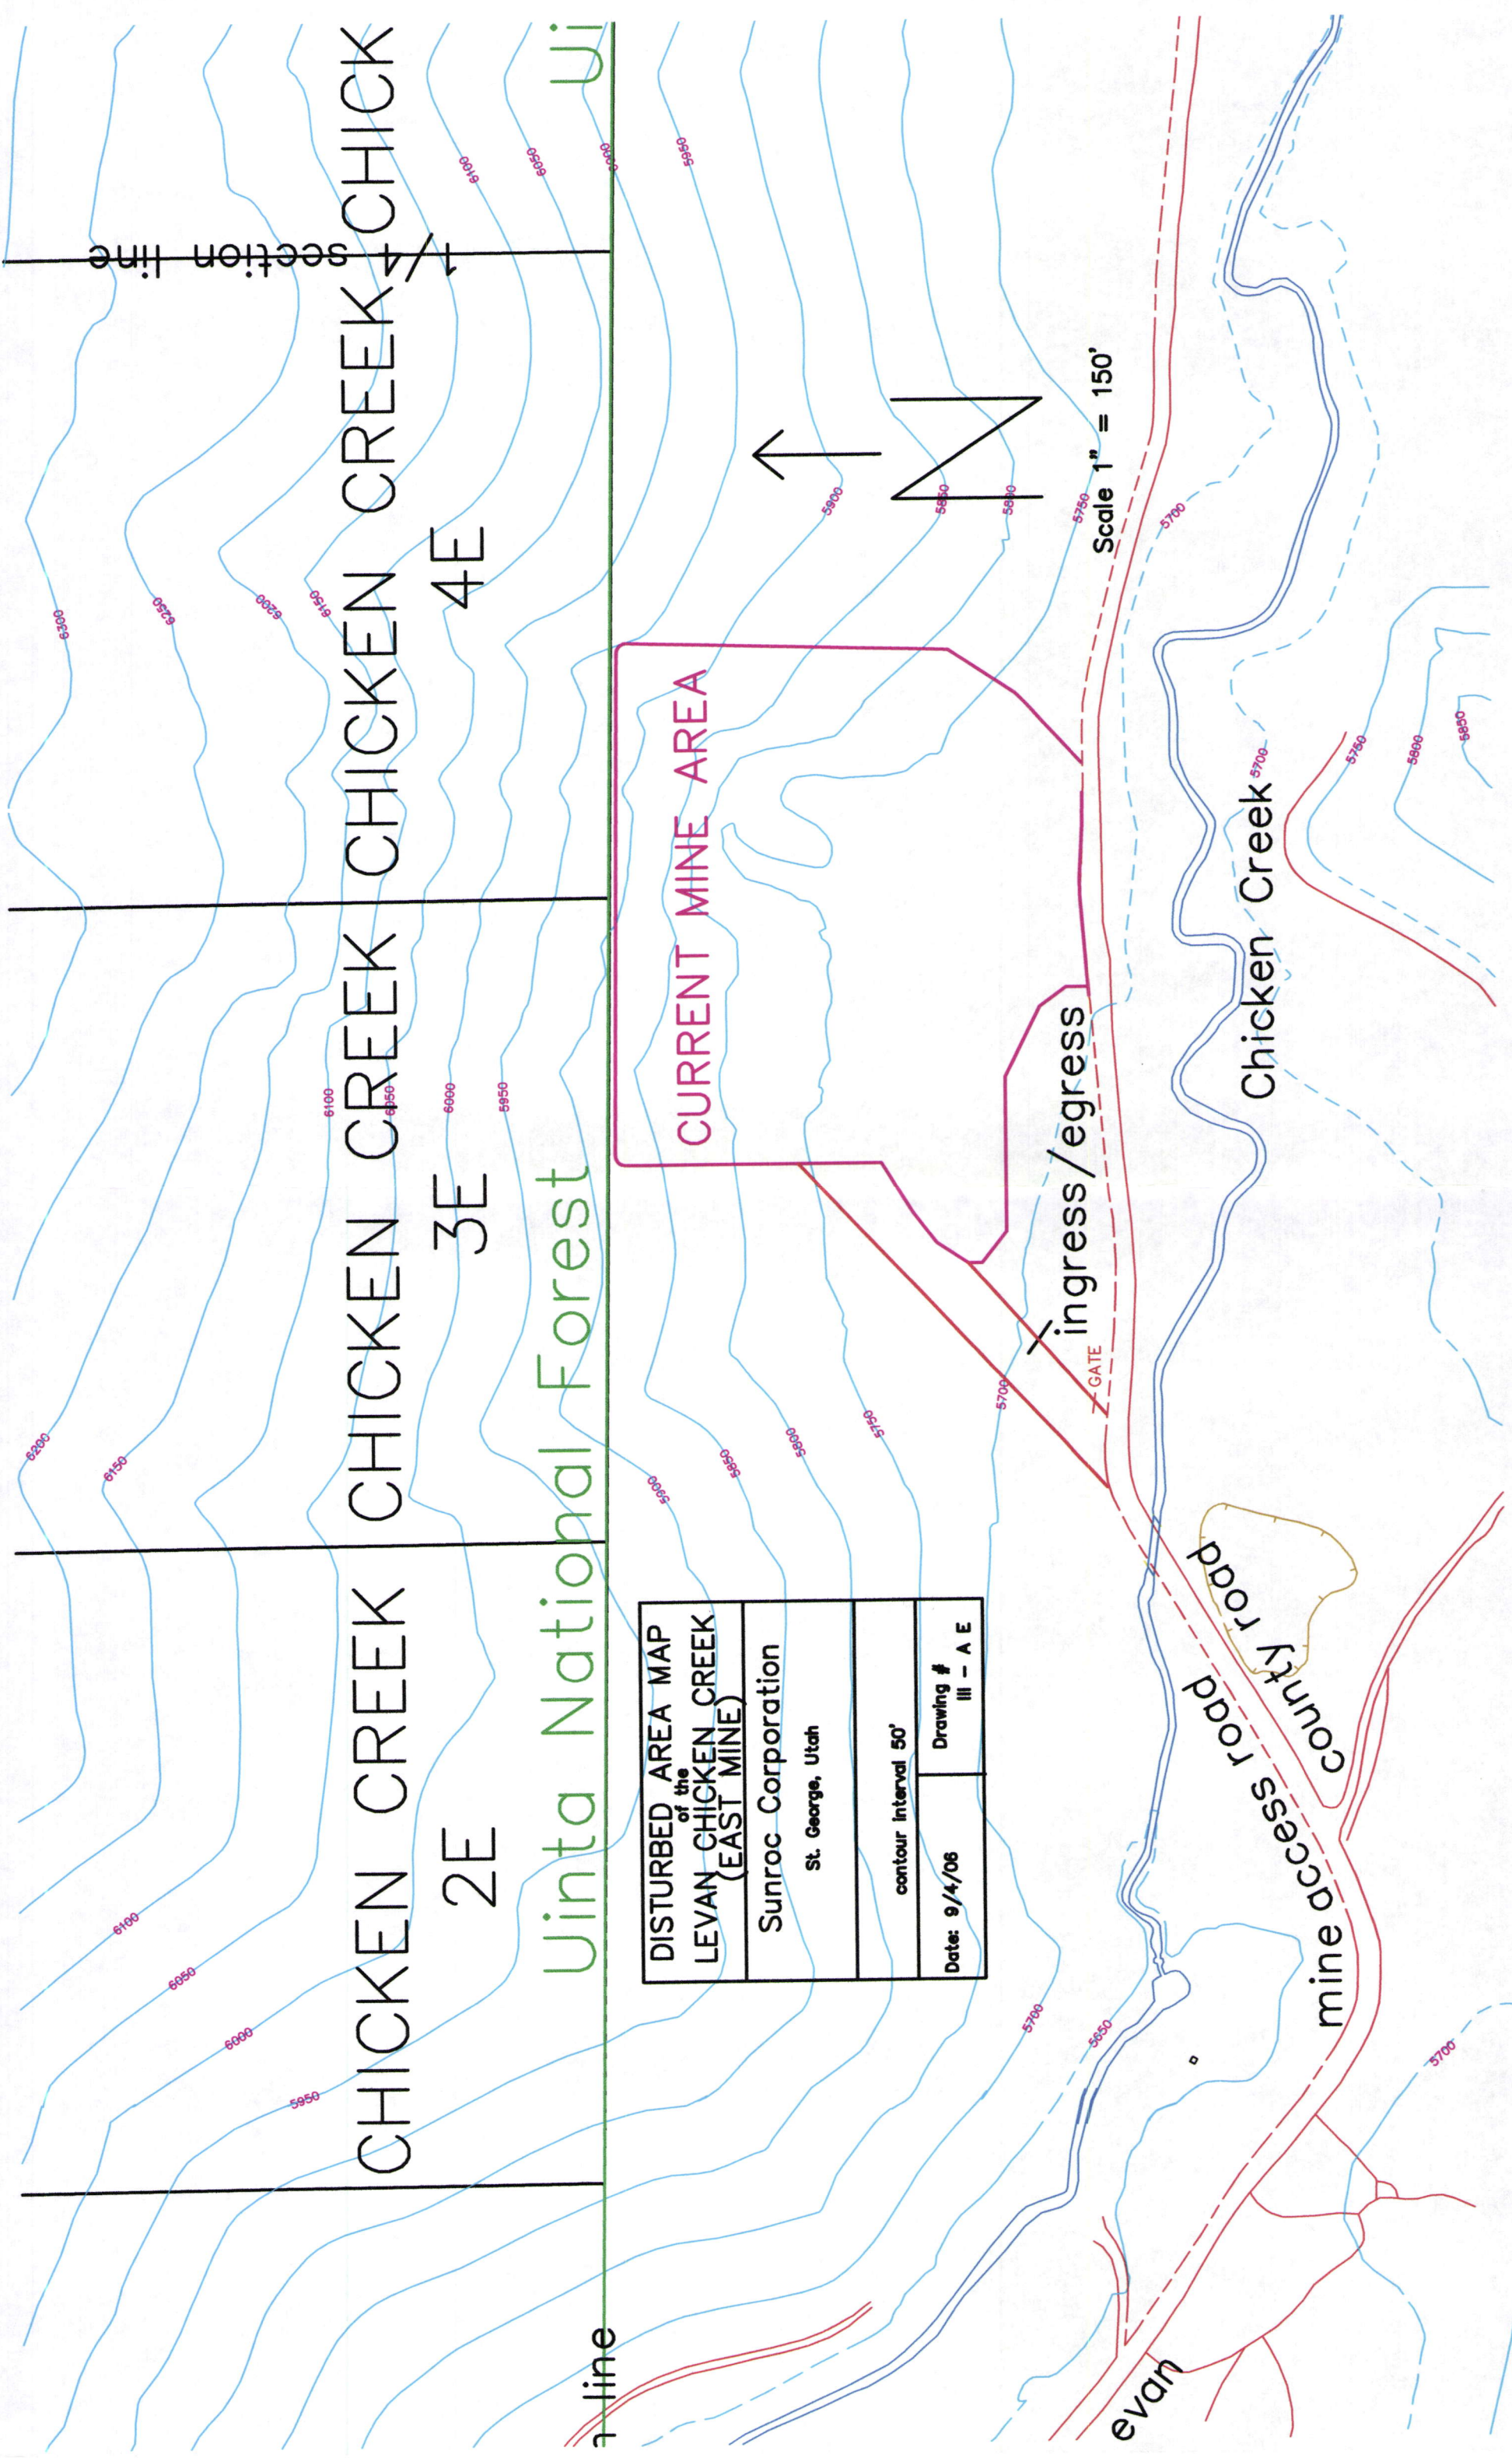

DISTURBED AREA MAP of the LEVAN CHICKEN CREEK (EAST MINE)	
Sunroc Corporation St. George, Utah	
contour interval 50'	
Date: 9/4/06	Drawing # III - A E